



REAR DORMER NOT VISIBLE TO FRONT

ROOFLIGHT TO STAIRS CONCEALED BY PORCH + NOT VISIBLE TO FRONT

DORMER IN ATTIC TO REAR. NO OVERLOOKING TO NEIGHBOURS. 26.7m TO REAR BOUNDARY

DOOR TO GARAGE SET BACK 9.3m FROM FRONT BOUNDARY



ROOFLIGHTS TO REAR



PLANNING SECTION
LEITRIM COUNTY COUNCIL

Rec'd 04.06.2025

REF: ED.25.24

FRONT S.E. ELEVATION

REAR N.W. ELEVATION

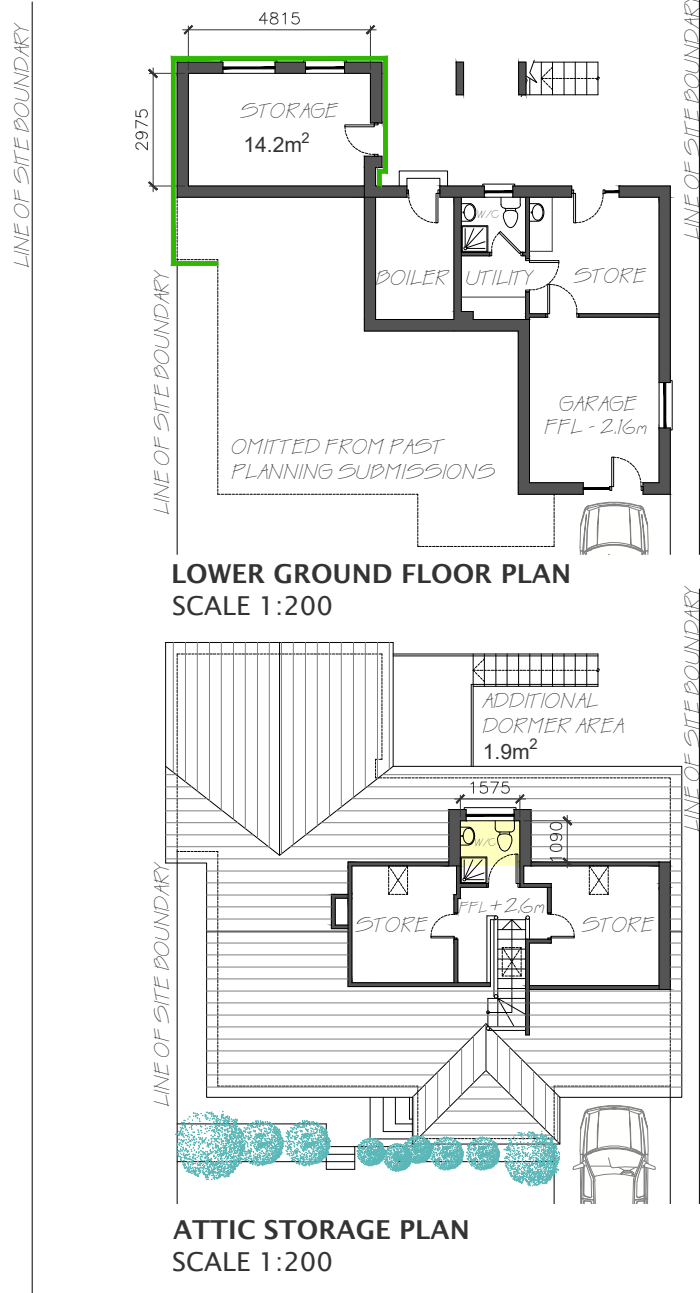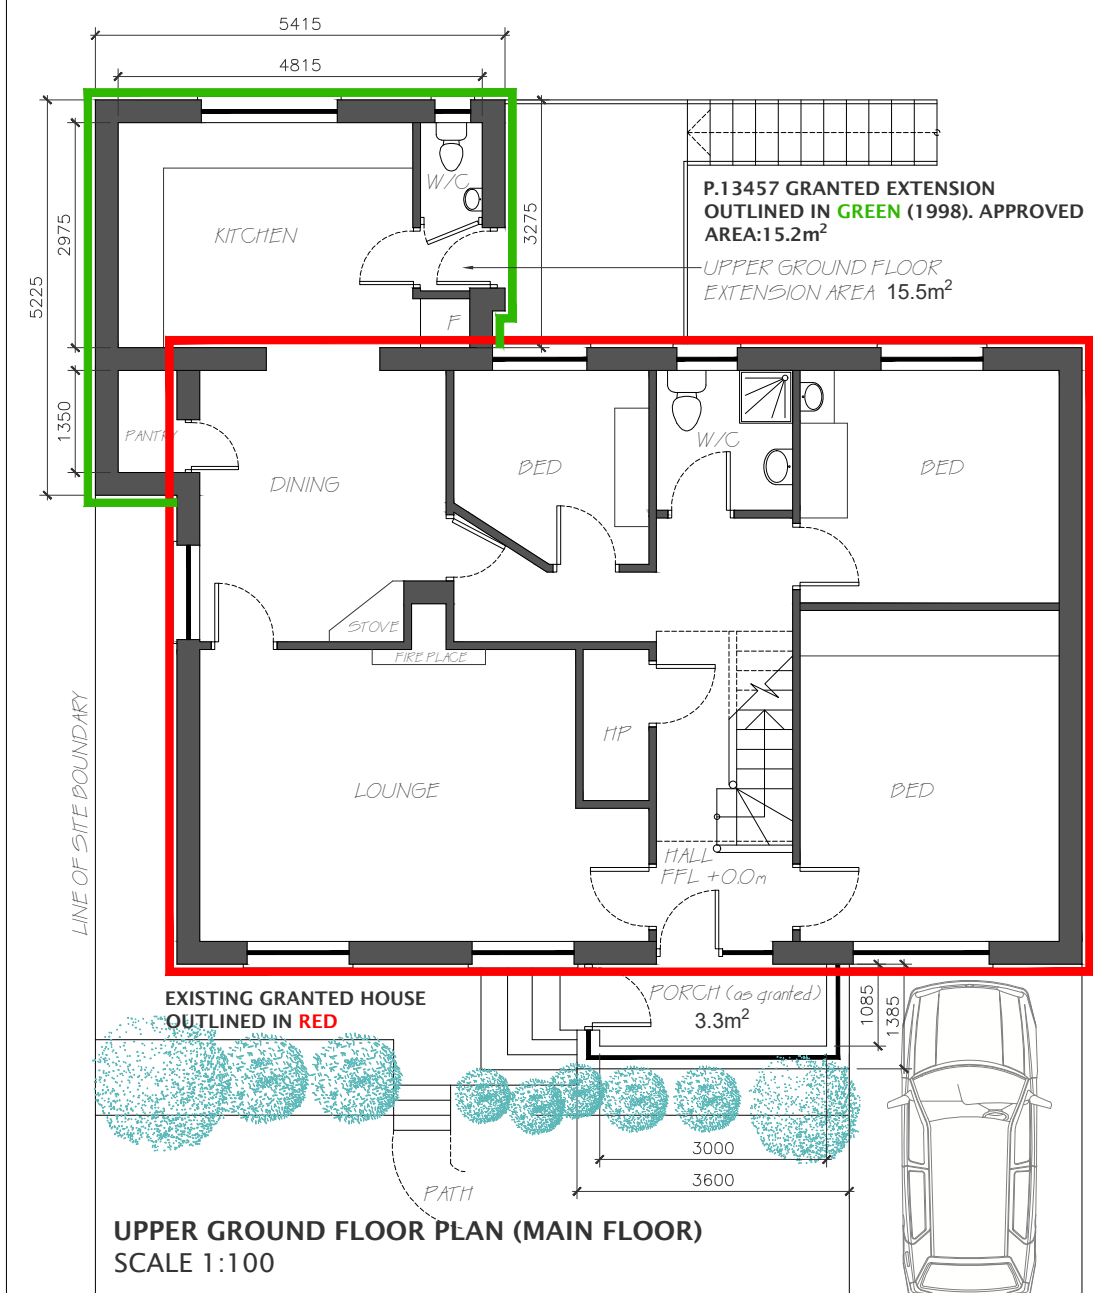

DORMER INSTALLED AT ATTIC W/C (NON-HABITABLE SPACE) NO OVERLOOKING TO NEIGHBOURS. 26.7m TO REAR BOUNDARY

2 NO. ROOFLIGHTS TO ATTIC STORAGE

WINDOW ADDED WITHIN GRANTED EXTENSION AREA

CHANGE FROM WINDOW TO DOOR

WINDOWS ADDED TO LOWER GROUND FLOOR STORAGE

DORMER LOWER THAN MAIN ROOF HEIGHT. NOT VISIBLE TO FRONT

REAR STEPS RECONFIGURED

ROOFLIGHT TO STAIRS CONCEALED BEHIND PORCH - SEE IMAGE ABOVE

SMALLER DOOR TO GARAGE SET BACK 9.3m FROM FRONT BOUNDARY

Rev	Date	Description	by
CLIENT: M. NOLAN			
PROJECT: SECTION 5 DECLARATION EXEMPTED DEVELOPMENT AT SKREENEY, MANORHAMILTON			
DRAWING TITLE: AS BUILT GENERAL ARRANGEMENT DRAWINGS			
DRAWINGS BY: LISA FOX 20A RENVILLE VILLAGE ORANMORE CO. GALWAY		SCALE: AS SHOWN DWG NO: 004	DATE: MAY 2025 REV: -