



SITE LAYOUT PLAN FROM P.00/776.

- (A) PROPOSED DWELLING.
- (B) PROPOSED BIT-MAC DRIVEWAY.
- (C) PROPOSED NEW ENTRANCE ONTO PUBLIC ROAD.
- (D) 100 mm dia. FOUL WATER CONNECTION DISCHARGING INTO MAINS SEWER.
- (E) EX. COUNTY COUNCIL MANHOLE.
- (F) PROPOSED 12.5 mm dia. CONNECTION TO EXISTING COUNTY COUNCIL WATER MAIN.
- (G) EXISTING COUNTY COUNCIL WATER MAIN.
- (H) EXISTING COUNTY COUNCIL FOUL SEWER
- (I) PROPOSED DOMESTIC GARAGE
- (J) SURFACE WATER TO DISCHARGE TO LAND DRAIN.
- (K) APPROXIMATE LOCATION OF SITE NOTICE.
- (L) PROPOSED 900 mm HIGH SOLID BLOCK WALL COMPLETE WITH WING WALLS AS SHOWN.
- (M) EXISTING HEDGEROW TO BE RETAINED.
- (N) PROPOSED TIMBER POST & RAIL FENCE TREATED WITH APPROVED PRESERVATIVE & BACKED WITH NATIVE HEDGEROW MATERIAL.
- (O) TWO-STOREY DW. HOUSE AND DOMESTIC GARAGE ALREADY GRANTED UNDER PLANNING REF. P. 00T18.

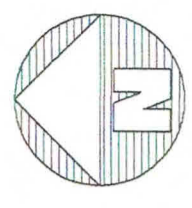

SITE OUTLINED IN RED

PLANNING SECTION  
LEITRIM COUNTY COUNCIL  
27/02/26  
REF. ED-26-11

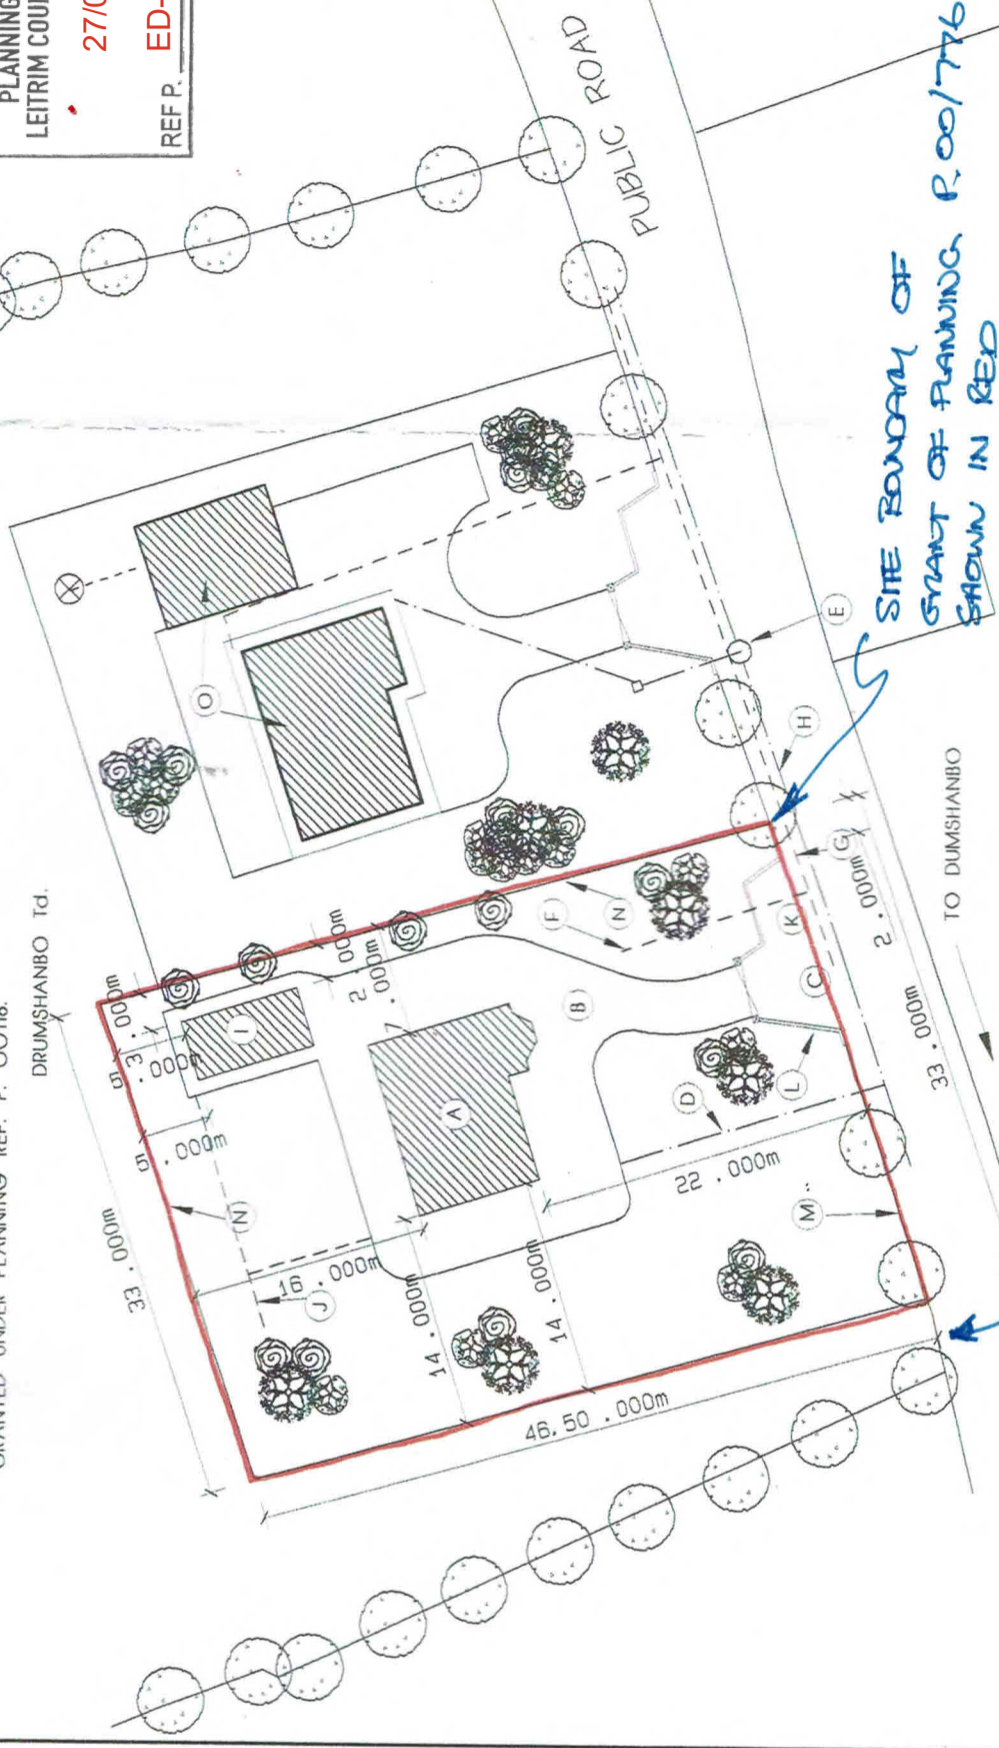

LOCATION OF GATE TO BE BUILT

SITE BOUNDARY OF GRANT OF PLANNING P.00/776 SHOWN IN RED

SITE MAP SCALE 1 : 500 O. S. LEITRIM NO. - 23 / 07, 08, 11 & 12

Copyright Licence CYAL50515547  
© Tailte Éireann - Surveying.

REV No	DATE	DESCRIPTION
<p><b>Advanced Planning &amp; Design Services Ltd.</b></p> <p>15A North West Business &amp; Technology Park Castlecarrig Road Carrick on Shannon Co Leitrim Phone/Fax: 071 9620776 Mobile: 086 1701549 Email: info@advancedplanninganddesign.com</p>		
<p><b>PROJECT</b></p> <p>SECTION 5 APPLICATION AT, DRUMSHANBO Td, DRUMSHANBO, CO LEITRIM FOR CALM O DONNELL</p>		
<p><b>TITLE</b></p> <p>SITE LAYOUT PLAN</p>		
<p><b>DRAWING NO</b></p> <p>P-000 - 0116/200</p>		<p><b>SCALE</b></p> <p>1:500 @ A3</p>
<p><b>DRAWN BY</b></p> <p>MICHAEL HENNESSY</p>		<p><b>DATE</b></p> <p>FEB 2016</p>